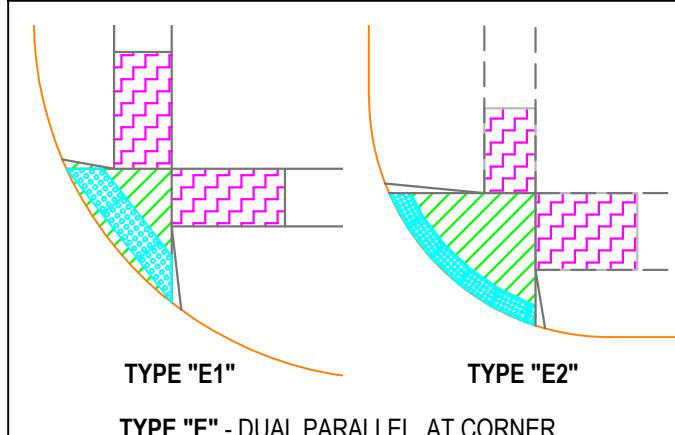
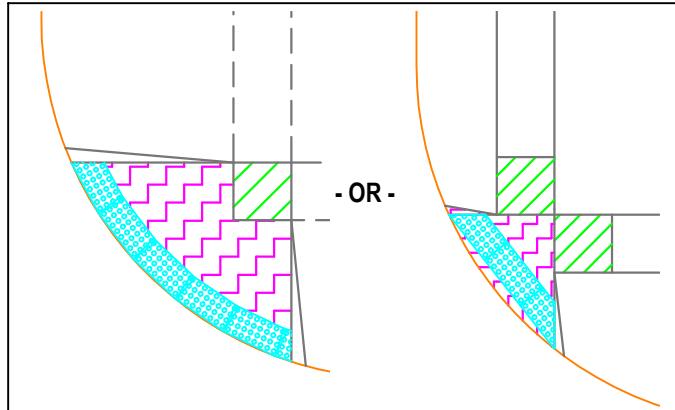


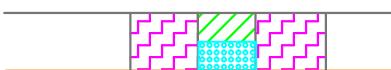
TYPE "A" - DUAL PERPENDICULAR, AT CORNER



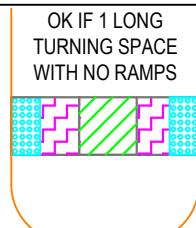
TYPE "E" - DUAL PARALLEL, AT CORNER



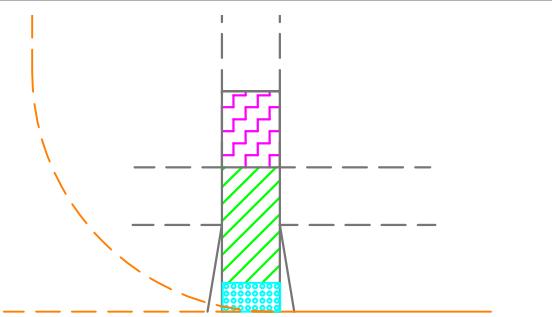
TYPE "F" - NON-COMPLIANT DUAL PARALLEL, AT CORNER
(Ramp and Turning Space Locations are Wrong - AKA "Flipped").
Existing Inventory only - No new As-Built condition should exist.)



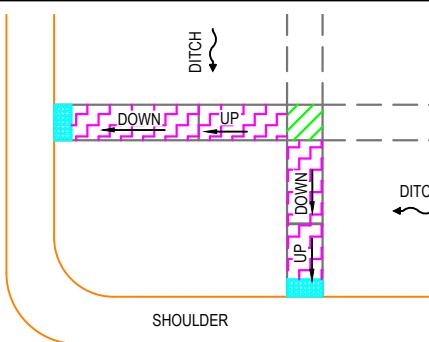
TYPE "C" - SINGLE PARALLEL AT BACK OF CURB



TYPE "M" - DOUBLE PERPENDICULAR THROUGH MEDIAN
Note: If median is less than 6' wide, no domes required.



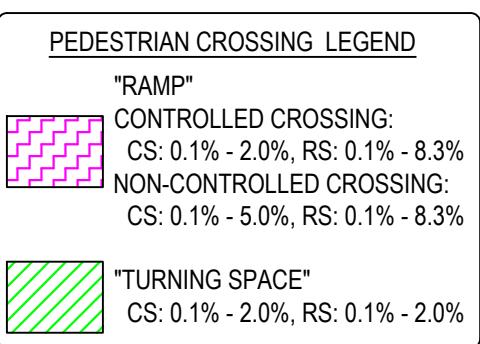
TYPE "D" - SINGLE PARALLEL AT MID-BLOCK OR CORNER



TYPE "R" - RURAL CROSSING

Crossing with 1 or more ramp intersecting a rural cross-section (no curb & gutter), regardless of the configuration. If the "ramp" running slope changes direction, measure as two ramps.

Ramps that do not meet any of the above situations: measure as possible & attach a photo &/or sketch to be reviewed individually.



TYPE "X" - UNIQUE CONFIGURATION

Project Name: _____

Project Type: _____

Construction Yr: _____

Project No.: _____

Crossing Status: _____

Applicable Std Yr: _____

As-Built By: _____

Date: _____

(If Justification exists, attach details)

PEDESTRIAN RAMP LEGEND**"RAMP"**

Controlled Crossing:

CS: 0.1% - 2.0%, RS: 0.1% - 8.3%

Non-Controlled Crossing:

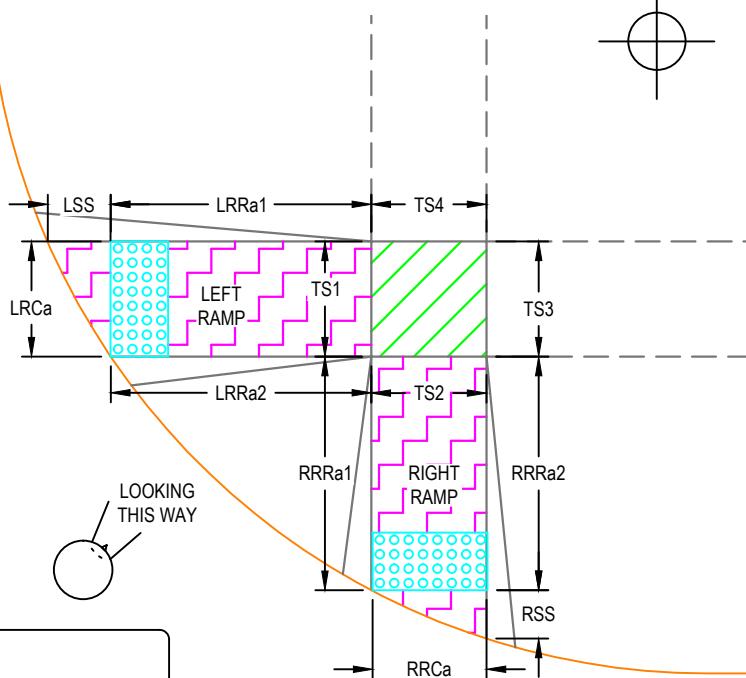
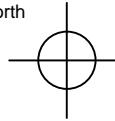
CS: 0.1% - 5.0%, RS: 0.1% - 8.3%

**"TURNING SPACE"**

CS: 0.1% - 2.0%, RS: 0.1% - 2.0%

Comments

Choose North

LEFT RAMP A

Left Ramp Crossing Control = _____

LSSa = Left Ramp Cross Slope (%) = _____

LSSa Width (FT) = _____

LSS = Left Special Shaping Length (FT) = _____

LRRa1 = Left Ramp1 Running Slope (%) = _____

LRRa2 = Left Ramp2 Running Slope (%) = _____

Does it have a Receiving Ramp? _____

Does a Trip Hazard Exist? _____

RIGHT RAMP A

Right Ramp Crossing Control = _____

RRCa = Right Ramp Cross Slope (%) = _____

RRCa Width (FT) = _____

RSS = Right Special Shaping Length (FT) = _____

RRRa1 = Right Ramp1 Running Slope (%) = _____

RRRa2 = Right Ramp2 Running Slope (%) = _____

Does it have a Receiving Ramp? _____

Does a Trip Hazard Exist? _____

TURNING SPACE DETAILS

Does a Trip Hazard Exist? _____

TS1 = Left Ramp Edge (%) = _____

TS1 Width (FT) = _____

TS2 = Right Ramp Edge (%) = _____

TS2 Width (FT) = _____

TS3 = Right Tie-In Edge (%) = _____

TS3 Width (FT) = _____

TS4 = Left Tie-In Edge (%) = _____

TS4 Width (FT) = _____

TRUNCATED DOMES

Are Truncated Domes at the BOC? _____

Are Truncated Domes across Full Width? _____

Are Truncated Domes Compliant? _____

Dome Color per City Supplemental Specs? _____

**PEDESTRIAN****CROSSING****AS-BUILT****RECORD****TYPE 'A'****DUAL****PERPENDICULAR****AT CORNER****(URBAN)**

GIS ID # _____

REVISED
09-01-2020

Project Name: _____

Project Type: _____

Construction Yr: _____

Project No.: _____

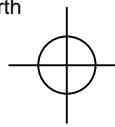
Crossing Status: _____

Applicable Std Yr: _____

As-Built By: _____ Date: _____

(If Justification exists, attach details)

Choose North

**PEDESTRIAN RAMP LEGEND****"RAMP"**

Controlled Crossing:

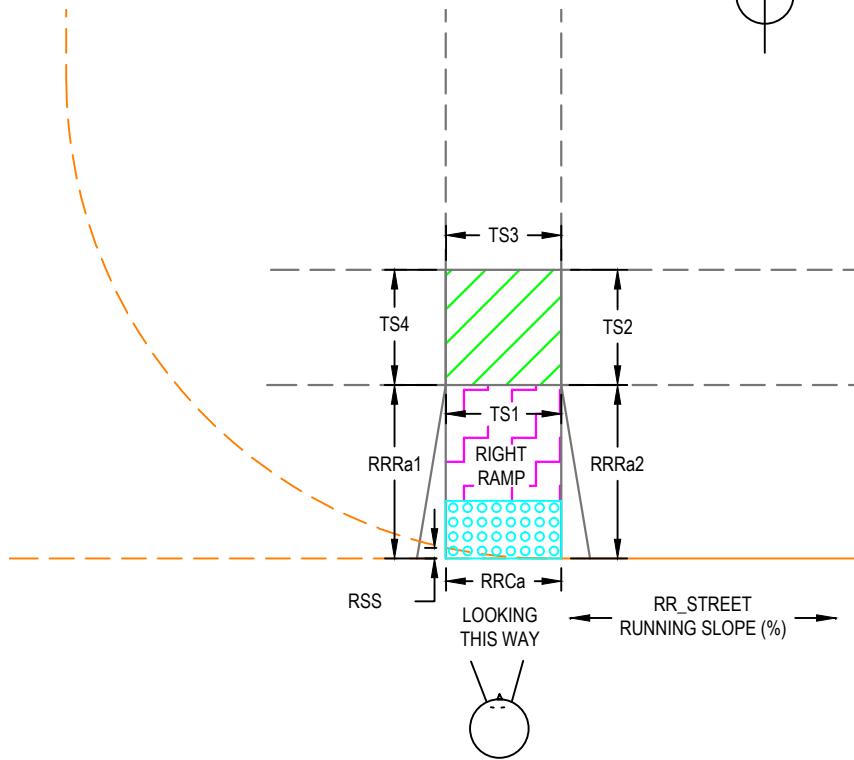
CS: 0.1% - 2.0%, RS: 0.1% - 8.3%

Non-controlled Crossing:

CS: 0.1% - 5.0%, RS: 0.1% - 8.3%

**"TURNING SPACE"**

CS: 0.1% - 2.0%, RS: 0.1% - 2.0%

Comments**RIGHT RAMP A**

Right Ramp Crossing Control = _____

RRCa = Right Ramp Cross Slope² (%) = _____

RRCa Width (FT) = _____

RSS = Right Special Shaping Length³ (FT) = _____RR_STREET Running Slope² (%) = _____

RRRa1 = Right Ramp1 Running Slope (%) = _____

RRRa2 = Right Ramp2 Running Slope (%) = _____

Does it have a Receiving Ramp? _____

Does a Trip Hazard Exist? _____

TRUNCATED DOMES

Are Truncated Domes at the BOC? _____

Are Truncated Domes across Full Width? _____

Are Truncated Domes Compliant? _____

Dome Color per City Supplemental Specs? _____

TURNING SPACE DETAILS

Does a Trip Hazard Exist? _____

TS1 = Left Ramp Edge (%) = _____

TS1 Width (FT) = _____

TS2 = Right Ramp Edge (%) = _____

TS2 Width (FT) = _____

TS3 = Right Tie-In Edge (%) = _____

TS3 Width (FT) = _____

TS4 = Left Tie-In Edge (%) = _____

TS4 Width (FT) = _____

NOTES:

1. When only a single crossing, consider the ramp a "Right Ramp".
2. For Mid-block crossings, RRC Cross Slope can match the RR_Street Running Slope when there is no crossing control or the crossing is signalized. If a situation like this exists where RRC is > 5%, explain in the comments.
3. RSS (Right Ramp Special Shaping Length) would equal zero unless on a radius. When along a radius, RSS is the maximum distance from the front of truncated domes to the back of curb.

**PEDESTRIAN CROSSING AS-BUILT RECORD - TYPE 'B'
SINGLE PERPENDICULAR AT MID-BLOCK OR CORNER (URBAN)**

GIS ID # _____

REVISED 09-01-2020



Project Name: _____

Project Type: _____

Construction Yr: _____

Project No.: _____

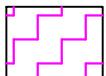
Crossing Status: _____

Applicable Std Yr: _____

As-Built By: _____

Date: _____

(If Justification exists, attach details)

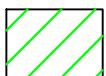
PEDESTRIAN RAMP LEGEND**"RAMP"**

Controlled Crossing:

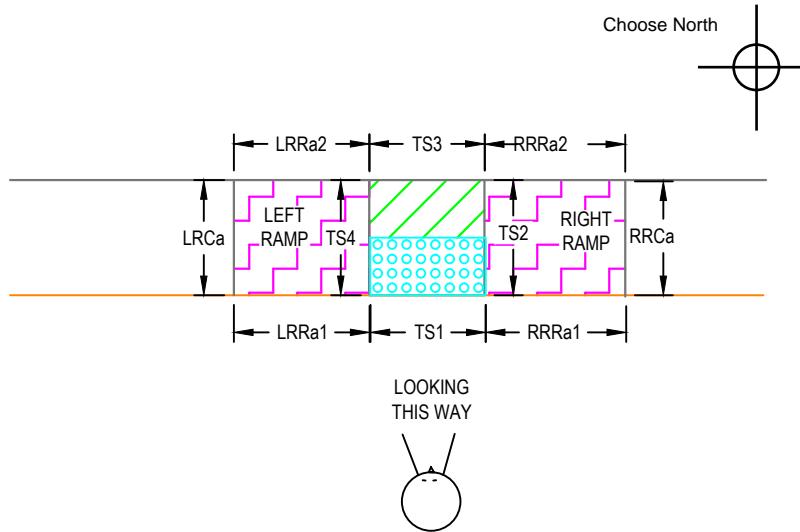
CS: 0.1% - 2.0%, RS: 0.1% - 8.3%

Non-Controlled Crossing:

CS: 0.1% - 5.0%, RS: 0.1% - 8.3%

**"TURNING SPACE"**

CS: 0.1% - 2.0%, RS: 0.1% - 2.0%

**LEFT RAMP A**

LRC a = Left Ramp Cross Slope (%) = _____

LRCa Width (FT) = _____

LRRa1 = Left Ramp1 Running Slope (%) = _____

LRRa2 = Left Ramp2 Running Slope (%) = _____

Does a Trip Hazard Exist? _____

RIGHT RAMP A

RRCa = Right Ramp Cross Slope (%) = _____

RRCa Width (FT) = _____

RRRa1 = Right Ramp1 Running Slope (%) = _____

RRRa2 = Right Ramp2 Running Slope (%) = _____

Does a Trip Hazard Exist? _____

TRUNCATED DOMES

Are Truncated Domes at the BOC? _____

Are Truncated Domes across Full Width? _____

Are Truncated Domes Compliant? _____

Dome Color per City Supplemental Specs? _____

Comments**TURNING SPACE DETAILS**

Does a Trip Hazard Exist? _____

TS1 = Left Ramp Edge Slope (%) = _____

TS1 Width (FT) = _____

TS2 = Right Ramp Edge Slope (%) = _____

TS2 Width (FT) = _____

TS3 = Right Tie-In Edge Slope (%) = _____

TS3 Width (FT) = _____

TS4 = Left Tie-In Edge Slope (%) = _____

TS4 Width (FT) = _____

Crossing Control¹ = _____

Does it have a Receiving Ramp? _____

SSL = Special Shaping Length² (FT) = _____**NOTES:**

1. Crossing control does not change anything for this type of crossing. Even when it is a mid-block crossing, the bottom cross-slope must be < 2% since it also acts as the turning space. It is not allowed to go up to 5% like a perpendicular ramp would be able to.
2. SSL (Special Shaping Length) would equal zero unless on a radius. When along a radius, SSL is the maximum distance from the front of truncated domes to the back of curb.

Project Name: _____

Project Type: _____

Construction Yr: _____

Project No.: _____

Crossing Status: _____

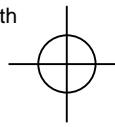
Applicable Std Yr: _____

As-Built By: _____

Date: _____

(If Justification exists, attach details)

Choose North

**PEDESTRIAN RAMP LEGEND****"RAMP"**

Controlled Crossing:

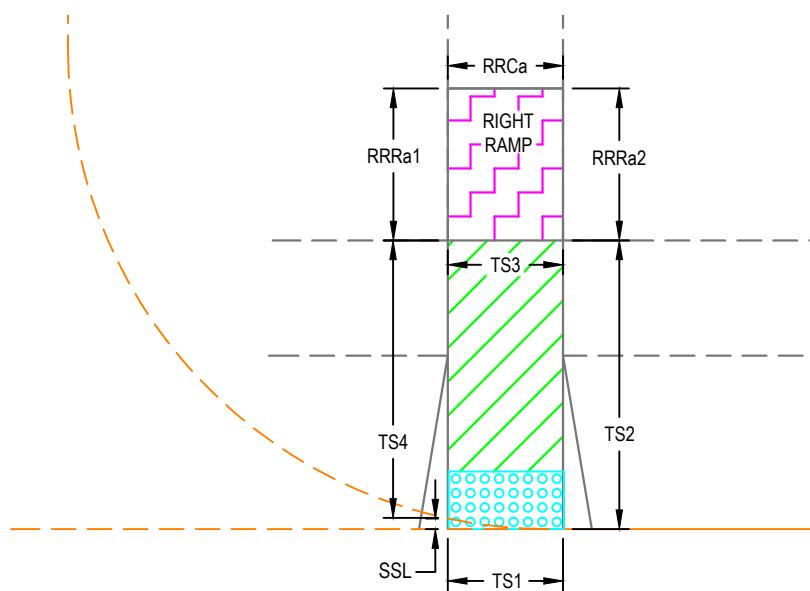
CS: 0.1% - 2.0%, RS: 0.1% - 8.3%

Non-Controlled Crossing:

CS: 0.1% - 5.0%, RS: 0.1% - 8.3%

**"TURNING SPACE"**

CS: 0.1% - 2.0%, RS: 0.1% - 2.0%

Comments**RIGHT RAMP ¹A**

RRCa = Right Ramp Cross Slope (%) = _____

RRCa Width (FT) = _____

RRRa1 = Right Ramp1 Running Slope (%) = _____

RRRa2 = Right Ramp2 Running Slope (%) = _____

Does a Trip Hazard Exist? _____

TRUNCATED DOMES

Are Truncated Domes at the BOC? _____

Are Truncated Domes across Full Width? _____

Are Truncated Domes Compliant? _____

Dome Color per City Supplemental Specs? _____

NOTES:

1. When only a single crossing, consider the ramp a "Right Ramp".
2. Crossing control does not change anything for this type of crossing. Even when it is a mid-block crossing, the bottom cross-slope must be < 2% since it also acts as the turning space. It is not allowed to go up to 5% like a perpendicular ramp would be able to.
3. SSL (Special Shaping Length) would equal zero unless on a radius. When along a radius, SSL is the maximum distance from the front of truncated domes to the back of curb.

TURNING SPACE DETAILS

Does a Trip Hazard Exist? _____

TS1 = Left Ramp Edge Slope (%) = _____

TS1 Width (FT) = _____

TS2 = Right Ramp Edge Slope (%) = _____

TS2 Width (FT) = _____

TS3 = Right Tie-In Edge Slope (%) = _____

TS3 Width (FT) = _____

TS4 = Left Tie-In Edge Slope (%) = _____

TS4 Width (FT) = _____

Crossing Control² = _____

Does it have a Receiving Ramp? _____

SSL = Special Shaping Length³ (FT) = _____

city of
Ankeny
bringing it all together

PUBLIC WORKS
DEPARTMENT
ENGINEERING
DIVISION
DWG
AS-BUILT TEMPLATES

PEDESTRIAN CROSSING AS-BUILT RECORD - TYPE 'D'
SINGLE PARALLEL AT MID-BLOCK OR CORNER (URBAN)
S:\PUBWORKS\ENGINEERING\DIVISION\ADA COMPLIANCE\RAMP_AS-BUILT\PEDESTRIAN CROSSING AS-BUILT TEMPLATES.DWG

GIS ID # _____

REVISED
09-01-2020

Project Name: _____

Project Type: _____

Construction Yr: _____

Project No.: _____

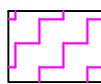
Crossing Status: _____

Applicable Std Yr: _____

As-Built By: _____

Date: _____

(If Justification exists, attach details)

PEDESTRIAN RAMP LEGEND**"RAMP"**

Controlled Crossing:

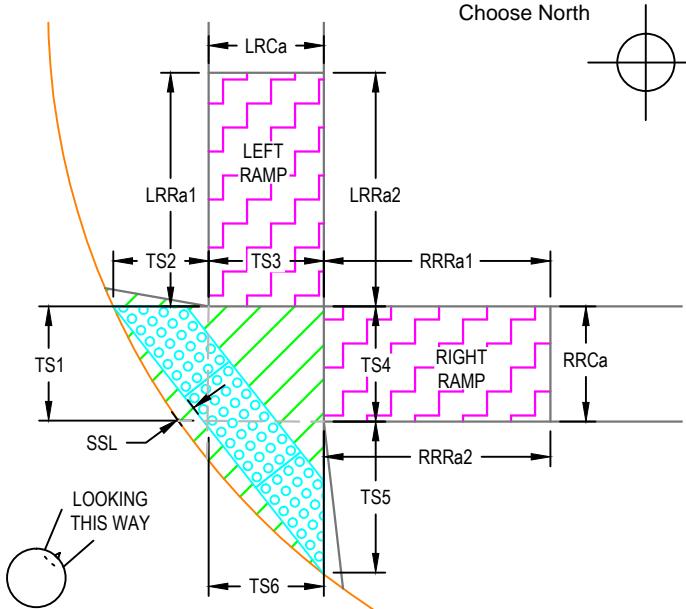
CS: 0.1% - 2.0%, RS: 0.1% - 8.3%

Non-Controlled Crossing:

CS: 0.1% - 5.0%, RS: 0.1% - 8.3%

"TURNING SPACE"

CS: 0.1% - 2.0%, RS: 0.1% - 2.0%

Comments**LEFT RAMP A**

LRCa = Left Ramp Cross Slope (%) = _____

LRCa Width (FT) = _____

LRRa1 = Left Ramp1 Running Slope (%) = _____

LRRa2 = Left Ramp2 Running Slope (%) = _____

Does a Trip Hazard Exist? _____

RIGHT RAMP A

RRCa = Right Ramp Cross Slope (%) = _____

RRCa Width (FT) = _____

RRRa1 = Right Ramp1 Running Slope (%) = _____

RRRa2 = Right Ramp2 Running Slope (%) = _____

Does a Trip Hazard Exist? _____

TRUNCATED DOMES

Are Truncated Domes at the BOC? _____

Are Truncated Domes across Full Width? _____

Are Truncated Domes Compliant? _____

Dome Color per City Supplemental Specs? _____

NOTES:

1. Crossing control does not change anything for this type of crossing. Even when it is a mid-block crossing, the bottom cross-slope must be < 2% since it also acts as the turning space. It is not allowed to go up to 5% like a perpendicular ramp would be able to.
2. SSL (Special Shaping Length) is the maximum distance from the front of truncated domes to the back of curb if not radial dome panels.
3. TS1 & TS6 measured from front of domes to edge of ramp, perpendicular to the pedestrian route (AKA cross-slope of crossing, not dome direction).

TURNING SPACE DETAILS

Does a Trip Hazard Exist? _____

TS1 = Left Crossing Edge Slope³ (%) = _____

TS1 Width (FT) = _____

TS2 = Left Tie-In Edge Slope (%) = _____

TS2 Width (FT) = _____

TS3 = Left Ramp Edge Slope (%) = _____

TS3 Width (FT) = _____

TS4 = Right Ramp Edge Slope (%) = _____

TS4 Width (FT) = _____

TS5 = Right Tie-In Edge Slope (%) = _____

TS5 Width (FT) = _____

TS6 = Rt Crossing Edge Slope³ (%) = _____

TS6 Width (FT) = _____

Crossing Control¹ = _____

Does it have a Receiving Ramp? _____

SSL = Special Shaping Length² (FT) = _____**PEDESTRIAN CROSSING AS-BUILT RECORD - TYPE 'E1'****PEDESTRIAN CROSSING AS-BUILT RECORD - DUAL PARALLEL AT CORNER (URBAN)**

GIS ID # _____

REVISED
09-01-2020

Project Name: _____

Project Type: _____

Construction Yr: _____

Project No.: _____

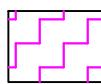
Crossing Status: _____

Applicable Std Yr: _____

As-Built By: _____

Date: _____

(If Justification exists, attach details)

PEDESTRIAN RAMP LEGEND**"RAMP"**

Controlled Crossing:

CS: 0.1% - 2.0%, RS: 0.1% - 8.3%

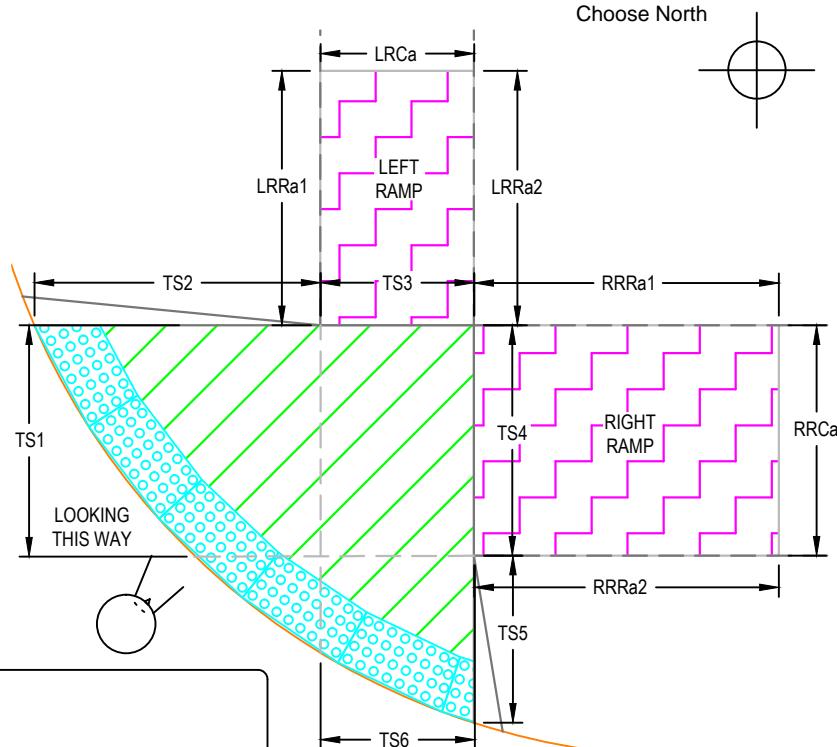
Non-Controlled Crossing:

CS: 0.1% - 5.0%, RS: 0.1% - 8.3%

"TURNING SPACE"

CS: 0.1% - 2.0%, RS: 0.1% - 2.0%

Comments _____

**LEFT RAMP A**

LRCa = Left Ramp Cross Slope (%) = _____

LRCa Width (FT) = _____

LRRa1 = Left Ramp1 Running Slope (%) = _____

LRRa2 = Left Ramp2 Running Slope (%) = _____

Does a Trip Hazard Exist? _____

RIGHT RAMP A

RRCa = Right Ramp Cross Slope (%) = _____

RRCa Width (FT) = _____

RRRa1 = Right Ramp1 Running Slope (%) = _____

RRRa2 = Right Ramp2 Running Slope (%) = _____

Does a Trip Hazard Exist? _____

TRUNCATED DOMES

Are Truncated Domes at the BOC? _____

Are Truncated Domes across Full Width? _____

Are Truncated Domes Compliant? _____

Dome Color per City Supplemental Specs? _____

NOTES:

1. Crossing control does not change anything for this type of crossing. Even when it is a mid-block crossing, the bottom cross-slope must be < 2% since it also acts as the turning space. It is not allowed to go up to 5% like a perpendicular ramp would be able to.
2. SSL (Special Shaping Length) is the maximum distance from the front of truncated domes to the back of curb if not radial dome panels.
3. TS1 & TS6 measured from front of domes to edge of ramp, perpendicular to the pedestrian route (AKA cross-slope of crossing, not dome direction).

TURNING SPACE DETAILS

Does a Trip Hazard Exist? _____

TS1 = Left Crossing Edge Slope³ (%) = _____

TS1 Width (FT) = _____

TS2 = Left Tie-In Edge Slope (%) = _____

TS2 Width (FT) = _____

TS3 = Left Ramp Edge Slope (%) = _____

TS3 Width (FT) = _____

TS4 = Right Ramp Edge Slope (%) = _____

TS4 Width (FT) = _____

TS5 = Right Tie-In Edge Slope (%) = _____

TS5 Width (FT) = _____

TS6 = Rt Crossing Edge Slope³ (%) = _____

TS6 Width (FT) = _____

Crossing Control¹ = _____

Does it have a Receiving Ramp? _____

SSL = Special Shaping Length² (FT) = _____**PEDESTRIAN CROSSING AS-BUILT RECORD - TYPE 'E2'****PEDESTRIAN CROSSING AS-BUILT RECORD - DUAL PARALLEL AT CORNER (URBAN)**

GIS ID # _____

REVISED
09-01-2020

Project Name: _____

Project Type: _____

Construction Yr: _____

Project No.: _____

Crossing Status: _____

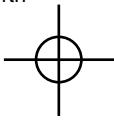
Applicable Std Yr: _____

As-Built By: _____

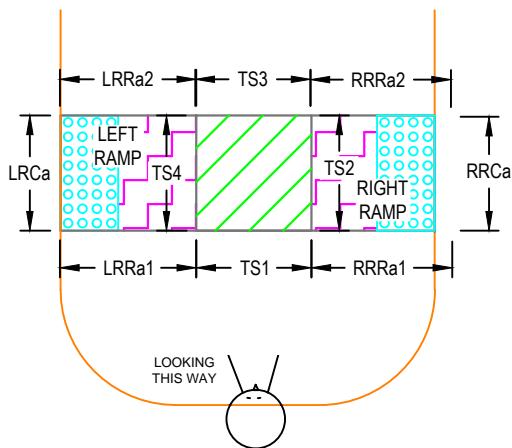
Date: _____

(If Justification exists, attach details)

Choose North

**PEDESTRIAN RAMP LEGEND****"RAMP"**Controlled Crossing:
CS: 0.1% - 2.0%, RS: 0.1% - 8.3%Non-Controlled Crossing:
CS: 0.1% - 5.0%, RS: 0.1% - 8.3%**"TURNING SPACE"**

CS: 0.1% - 2.0%, RS: 0.1% - 2.0%

**LEFT RAMP A**

Left Ramp Crossing Control = _____

LRCA = Left Ramp Cross Slope (%) = _____

LRCA Width (FT) = _____

LSS = Left Special Shaping Length² (FT) = _____

LRRa1 = Left Ramp1 Running Slope (%) = _____

LRRa2 = Left Ramp2 Running Slope (%) = _____

Does it have a Receiving Ramp? _____

Does a Trip Hazard Exist? _____

RIGHT RAMP A

Right Ramp Crossing Control = _____

RRCA = Right Ramp Cross Slope (%) = _____

RRCA Width (FT) = _____

RSS = Right Special Shaping Length² = _____

RRRa1 = Right Ramp1 Running Slope (%) = _____

RRRa2 = Right Ramp2 Running Slope (%) = _____

Does it have a Receiving Ramp? _____

Does a Trip Hazard Exist? _____

TRUNCATED DOMESAre Truncated Domes at the BOC¹? _____

Are Truncated Domes across Full Width? _____

Are Truncated Domes Compliant? _____

Dome Color per City Supplemental Specs? _____

Comments**TURNING SPACE DETAILS**

Does a Trip Hazard Exist? _____

TS1 = Left Ramp Edge (%) = _____

TS1 Width (FT) = _____

TS2 = Right Ramp Edge (%) = _____

TS2 Width (FT) = _____

TS3 = Right Tie-In Edge (%) = _____

TS3 Width (FT) = _____

TS4 = Left Tie-In Edge (%) = _____

TS4 Width (FT) = _____

NOTES:

1. Domes are only required when the total width of the median (AKA total length of crossing) is larger than six feet (6'). When less than 6 feet, there should still be a turning space for the pedestrian route, but no "ramps" or truncated domes are required.
2. RSS (Right Ramp Special Shaping Length) and LSS (Left Ramp Special Shaping Length) should equal zero unless on a radius. When along a radius, RSS & LSS are the maximum distance from the front of truncated domes to the back of curb for the associated ramp. GIS is intended to track the larger of the two values.

PEDESTRIAN CROSSING AS-BUILT RECORD - TYPE 'M' DOUBLE PERPENDICULAR THROUGH MEDIAN (URBAN)

GIS ID # _____

REVISED
09-01-2020

Project Name: _____

Project Type: _____

Construction Yr: _____

Project No.: _____

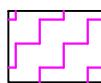
Crossing Status _____

Applicable Std Yr: _____

As-Built By: _____

Date: _____

(If Justification exists, attach details)

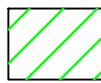
PEDESTRIAN RAMP LEGEND**"RAMP"**

Controlled Crossing:

CS: 0.1% - 2.0%, RS: 0.1% - 8.3%

Non-Controlled Crossing:

CS: 0.1% - 5.0%, RS: 0.1% - 8.3%

**"TURNING SPACE"**

CS: 0.1% - 2.0%, RS: 0.1% - 2.0%

Comments _____

Note:

1. This is a commonly observed rural crossing. Directions shown are just an example for up to 4 Ramps (2-Right & 2-Left). Modify other crossing types as needed in rural situations.
2. RSS & LSS (Right & Left Ramp Special Shaping Length) are the maximum distance from the front of truncated domes to the edge of shoulder.

LEFT RAMP A

Left Ramp Crossing Control = _____

LRCa = Left Ramp Cross Slope (%) = _____

LRCa Width (FT) = _____

LSS = Left Special Shaping Length² (FT) = _____

LRRa1 = Left Ramp a1 Run Slope (%) = _____

LRRa2 = Left Ramp a2 Run Slope (%) = _____

Does it have a Receiving Ramp? _____

Does a Trip Hazard Exist? _____

LEFT RAMP B

LRCb = Left Ramp Cross Slope (%) = _____

LRCb Width (FT) = _____

LRRb1 = Left Ramp b1 Run Slope (%) = _____

LRRb2 = Left Ramp b2 Run Slope (%) = _____

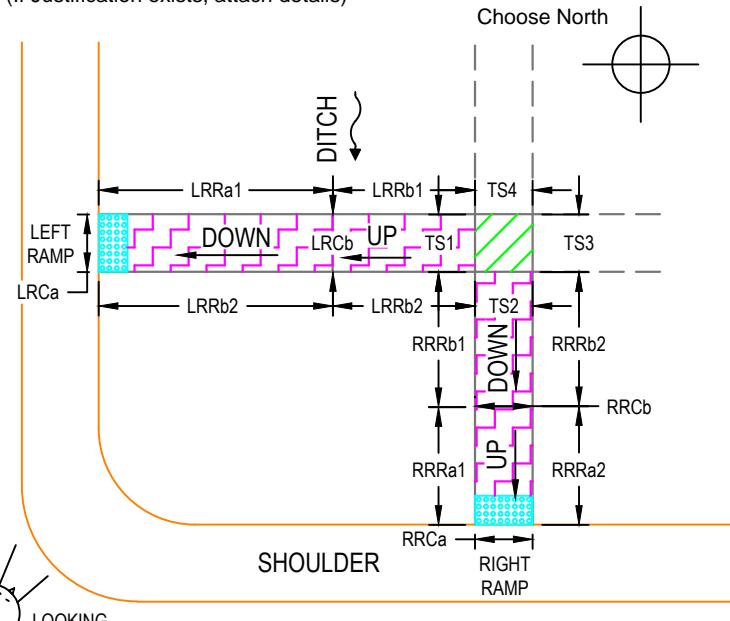
TRUNCATED DOMES

Are Truncated Domes at the Edge of Shoulder? _____

Are Truncated Domes across Full Width? _____

Are Truncated Domes Compliant? _____

Dome Color per City Supplemental Specs? _____

**RIGHT RAMP A**

Right Ramp Crossing Control = _____

RRCa = Right Ramp Cross Slope (%) = _____

RRCa Width (FT) = _____

RSS = Right Special Shaping Length² (FT) = _____

RRRa1 = Right Ramp a1 Run Slope (%) = _____

RRRa2 = Right Ramp a2 Run Slope (%) = _____

Does it have a Receiving Ramp? _____

Does a Trip Hazard Exist? _____

RIGHT RAMP B

RRCb = Right Ramp Cross Slope (%) = _____

RRCb Width (FT) = _____

RRRb1 = Right Ramp b1 Run Slope (%) = _____

RRRb2 = Right Ramp b2 Run Slope (%) = _____

TURNING SPACE DETAILS

Does a Trip Hazard Exist? _____

TS1 = Left Ramp Edge (%) = _____

TS1 Width (FT) = _____

TS2 = Right Ramp Edge (%) = _____

TS2 Width (FT) = _____

TS3 = Right Tie-In Edge (%) = _____

TS3 Width (FT) = _____

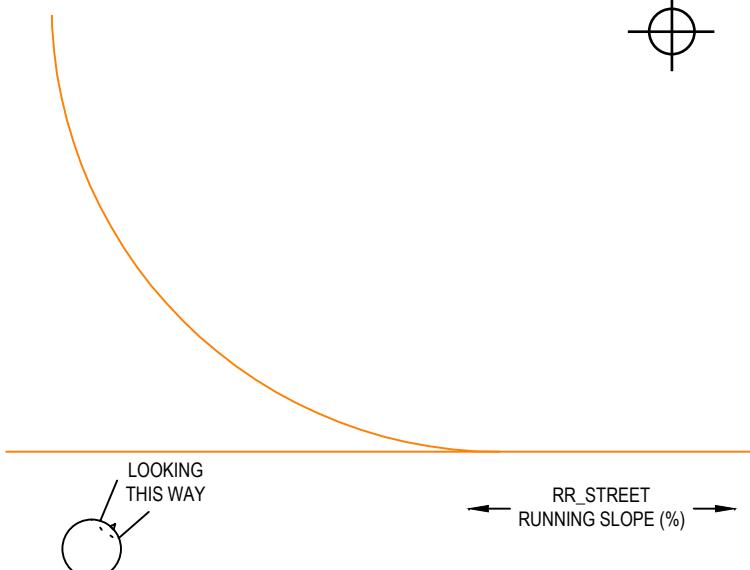
TS4 = Left Tie-In Edge (%) = _____

TS4 Width (FT) = _____

PEDESTRIAN CROSSING AS-BUILT RECORD - TYPE 'R'**PEDESTRIAN CROSSING AS-BUILT RECORD - DUAL PERPENDICULAR AT CORNER (RURAL)**

GIS ID # _____

REVISED
09-01-2020

<p>Project Name: _____ Project Type: _____</p> <p>Project No.: _____ Crossing Status: _____</p> <p>As-Built By: _____ Date: _____</p> <p style="border: 1px solid black; padding: 5px; margin-top: 10px;">PEDESTRIAN RAMP LEGEND</p> <p>"RAMP"  Controlled Crossing: CS: 0.1% - 2.0%, RS: 0.1% - 8.3%</p> <p>Non-Controlled Crossing: CS: 0.1% - 5.0%, RS: 0.1% - 8.3%</p> <p>"TURNING SPACE"  CS: 0.1% - 2.0%, RS: 0.1% - 2.0%</p>	<p>Construction Yr: _____</p> <p>Applicable Std Yr: _____</p> <p>Choose North </p> <p>Comments</p> 	<p style="text-align: right;">PUBLIC WORKS DEPARTMENT ENGINEERING DIVISION DWG</p> <p>city of Ankeny Bringing it all together</p> <p style="text-align: right;">S:\PUBWORKS\ENGINEERING\DIVISION\ADA COMPLIANCE\RAMP_AS-BUILT\PEDESTRIAN_RAMPS_AS-BUILT\TEMPLATES\DWG</p> <p style="text-align: right;">PEDESTRIAN CROSSING AS-BUILT RECORD - TYPE 'X' UNIQUE CONFIGURATION (URBAN)</p> <p>GIS ID # REVISED 09-01-2020</p>
<p>LEFT RAMP² A</p> <p>Left Ramp Crossing Control = _____</p> <p>LRCa = Left Ramp Cross Slope (%) = _____</p> <p>LRCa Width (FT) = _____</p> <p>LSS = Left Special Shaping Length (FT) = _____</p> <p>LRRa1 = Left Ramp1 Running Slope (%) = _____</p> <p>LLRa2 = Left Ramp2 Running Slope (%) = _____</p> <p>Does it have a Receiving Ramp? _____</p> <p>Does a Trip Hazard Exist? _____</p> <p>RIGHT RAMP^{1,2} A</p> <p>Right Ramp Crossing Control = _____</p> <p>RRCa = Right Ramp Cross Slope (%) = _____</p> <p>RRCa Width (FT) = _____</p> <p>RSS = Right Special Shaping Length (FT) = _____</p> <p>RRRa1 = Right Ramp1 Running Slope (%) = _____</p> <p>RRRa2 = Right Ramp2 Running Slope (%) = _____</p> <p>Does it have a Receiving Ramp? _____</p> <p>Does a Trip Hazard Exist? _____</p> <p>TRUNCATED DOMES</p> <p>Are Truncated Domes at the BOC? _____</p> <p>Are Truncated Domes across Full Width? _____</p> <p>Are Truncated Domes Compliant? _____</p> <p>Dome Color per City Supplemental Specs? _____</p>		<p>TURNING SPACE 1 DETAILS</p> <p>Does a Trip Hazard Exist? _____</p> <p>TS1 = Left Ramp Edge (%) = _____</p> <p>TS1 Width (FT) = _____</p> <p>TS2 = Right Ramp Edge (%) = _____</p> <p>TS2 Width (FT) = _____</p> <p>TS3 = Right Tie-In Edge (%) = _____</p> <p>TS3 Width (FT) = _____</p> <p>TS4 = Left Tie-In Edge (%) = _____</p> <p>TS4 Width (FT) = _____</p> <p>TURNING SPACE 2 DETAILS</p> <p>TS5 = Left Ramp Edge (%) = _____</p> <p>TS5 Width (FT) = _____</p> <p>TS6 = Right Ramp Edge (%) = _____</p> <p>TS6 Width (FT) = _____</p> <p>TS7 = Right Tie-In Edge (%) = _____</p> <p>TS7 Width (FT) = _____</p> <p>TS8 = Left Tie-In Edge (%) = _____</p> <p>TS8 Width (FT) = _____</p> <p>NOTES:</p> <ol style="list-style-type: none"> 1. When only a single crossing, consider the ramp a "Right Ramp". 2. If more than two (2) ramps exist, use multiple Type 'X' worksheets to display data, but only 1 drawing is necessary. Second set of ramps would be "Right Ramp B" and "Left Ramp B". 3. Attach supporting information or drawings as necessary.